


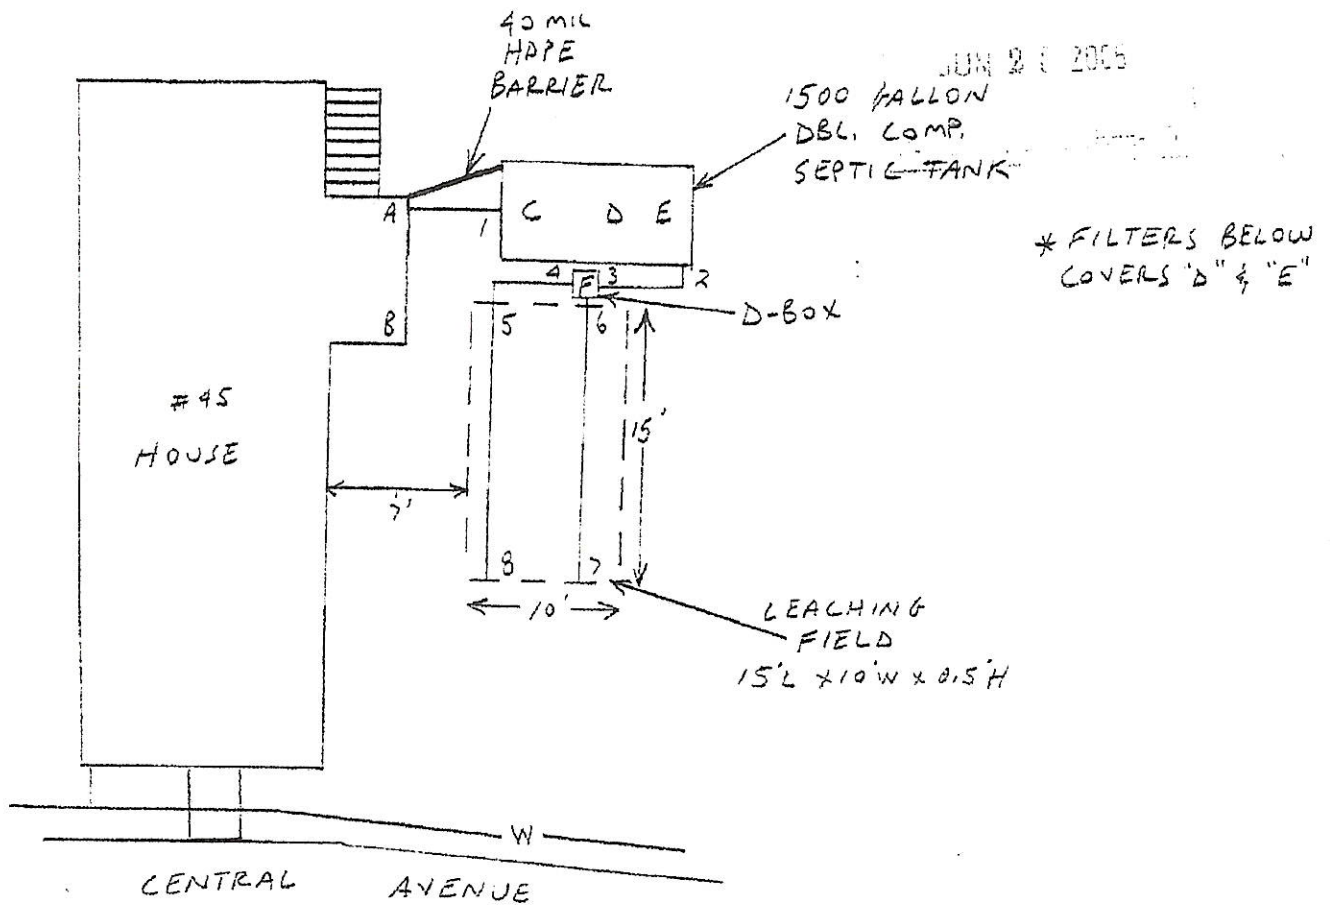

### TIES TO SEPTIC COMPONENTS

|            |            |
|------------|------------|
| AC - 6'3"  | AE - 13'8" |
| BC - 10'2" | BE - 15'6" |
| AD - 11'2" | AF - 10'1" |
| BD - 13'5" | BF - 10'0" |

### INVERTS OF PIPES

|           |           |
|-----------|-----------|
| 1 - 95.69 | 5 - 95.07 |
| 2 - 95.40 | 6 - 95.08 |
| 3 - 95.27 | 7 - 94.97 |
| 4 - 95.10 | 8 - 94.99 |



AS-BUILT PLAN

45 CENTRAL AVE, HAMILTON

DOMESTIC SEPTIC DESIGN, INC.  
P.O. BOX 831  
OSTERVILLE, MA 02655

DATE:  
6/23/06

SCALE:  
1" = 10'